


INDIAN RIVER NORTH

NOTE: RIPARIAN LINES NOT DETERMINED

POOL SETBACK  
10' OFF  
PROPERTY  
LINES NORTH  
\$504TH

POOL SETBACK  
IS 15' FEET  
OFF OF HOUSE

SCALE: 1"=10'

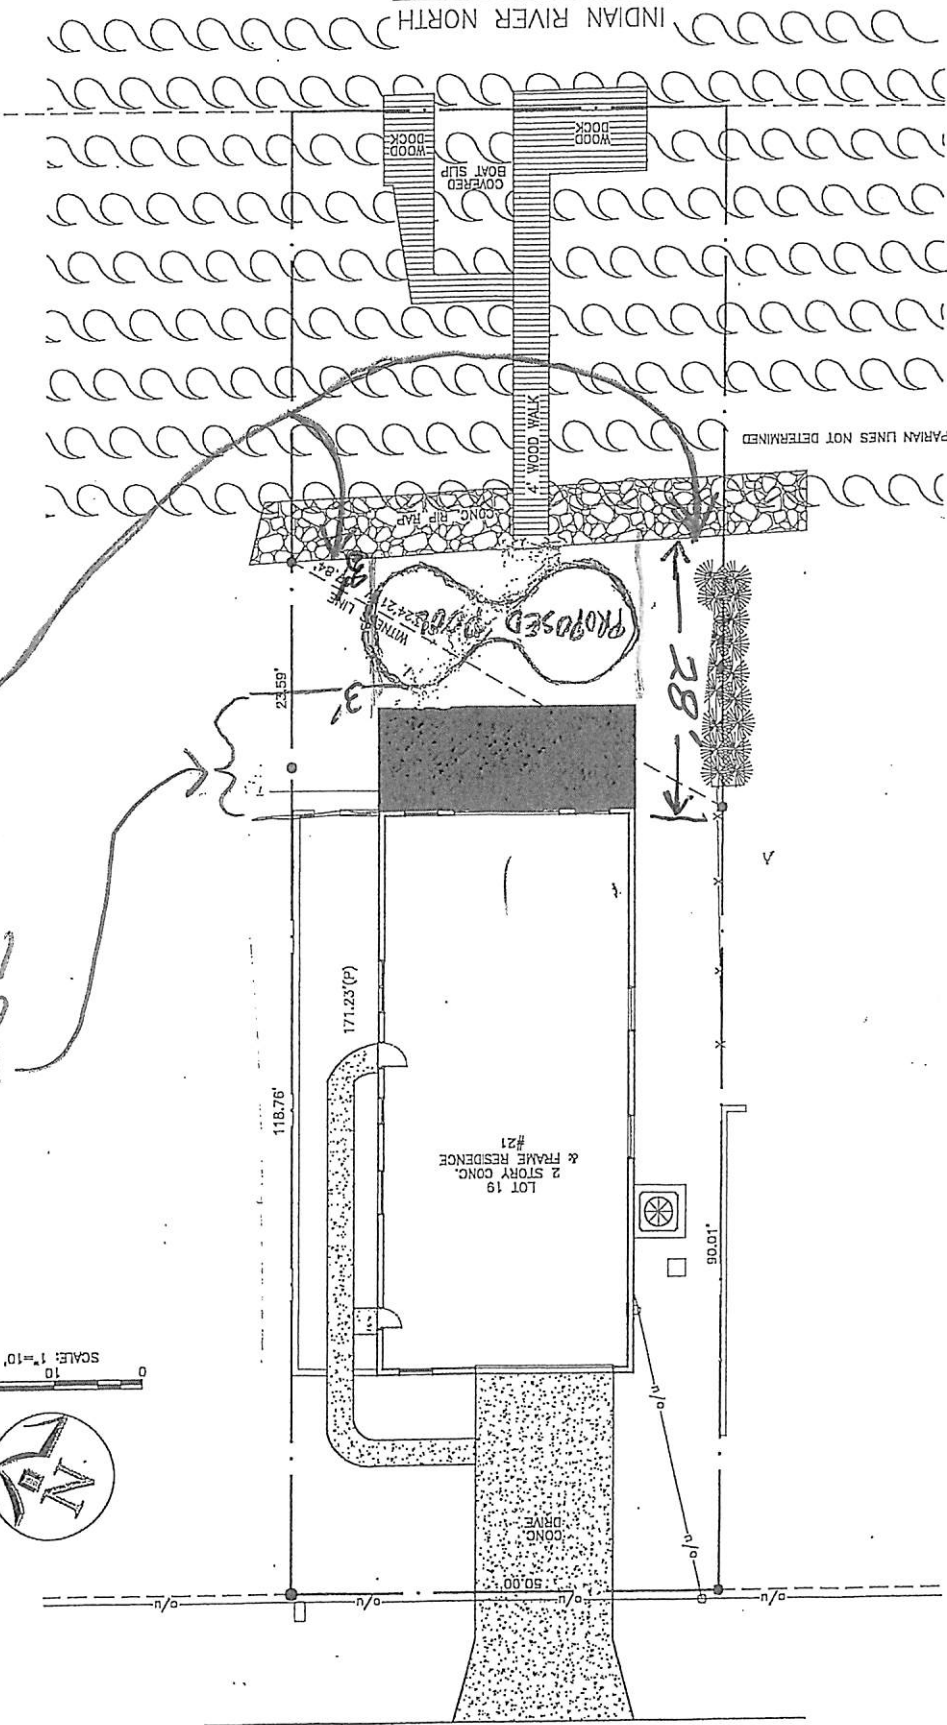


## 21 PELICAN LAKE EDGEWATER FL IMPERVIOUS CALCULATION


|                       |          |             |
|-----------------------|----------|-------------|
| LOT SIZE              | 171'x50' | = 8550 SF   |
| Less: HOUSE FOOTPRINT | 60'x30'  | < 1800 SF > |
| PATIO                 | 12'x30'  | < 360 SF >  |
| PAVERS WALKS          | 60'x4'   | < 240 SF >  |
| DRIVES                | 30'x20'  | < 600 SF >  |
| PROPOSED POOL AREA    | 30'x16'  | < 480 SF >  |
| NET PERVIOUS AREA     |          | 5070 SF     |


$$\begin{aligned} 5070 / 8550 &= 59\% \text{ PERVIOUS AREA} \\ 3480 / 8550 &= 41\% \text{ IMPERVIOUS AREA} \end{aligned}$$


BASED ON THE ABOVE THE IMPERVIOUS AREA  
OF 41% IS WELL BELOW THE MAXIMUM 60%.

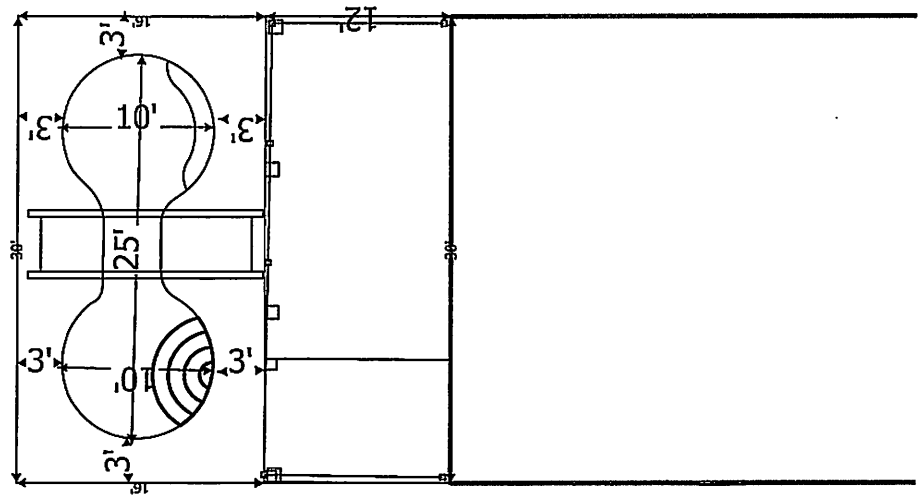

Scale: 1/8" = 1 ft

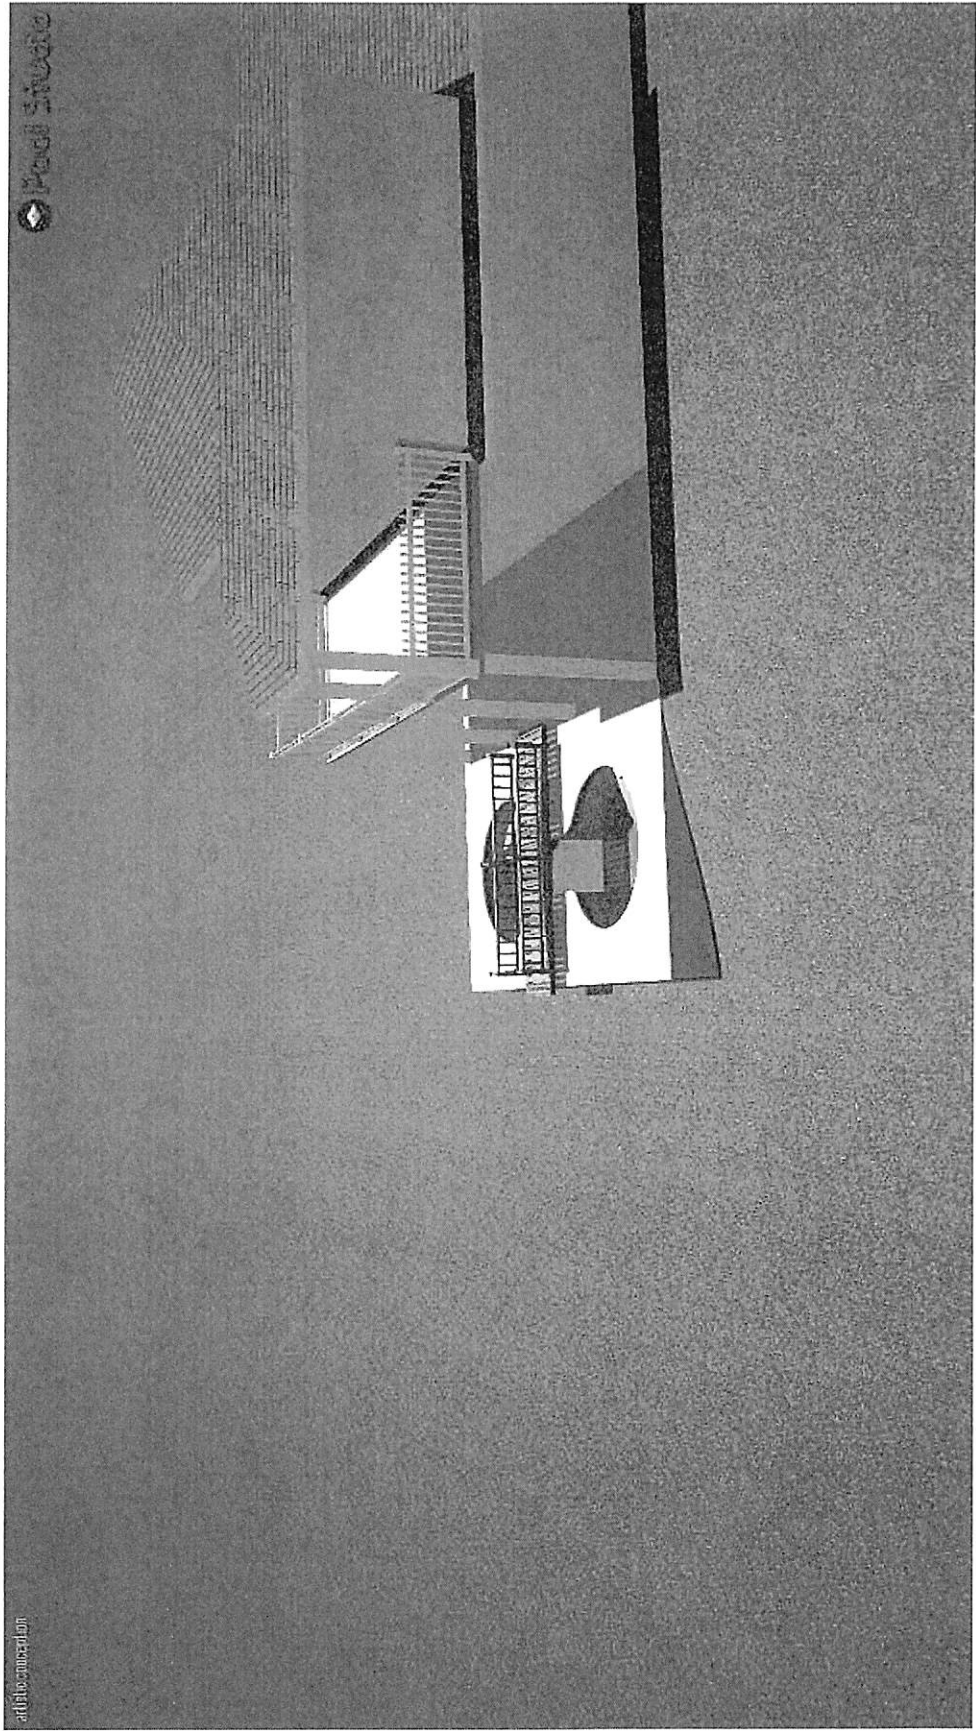


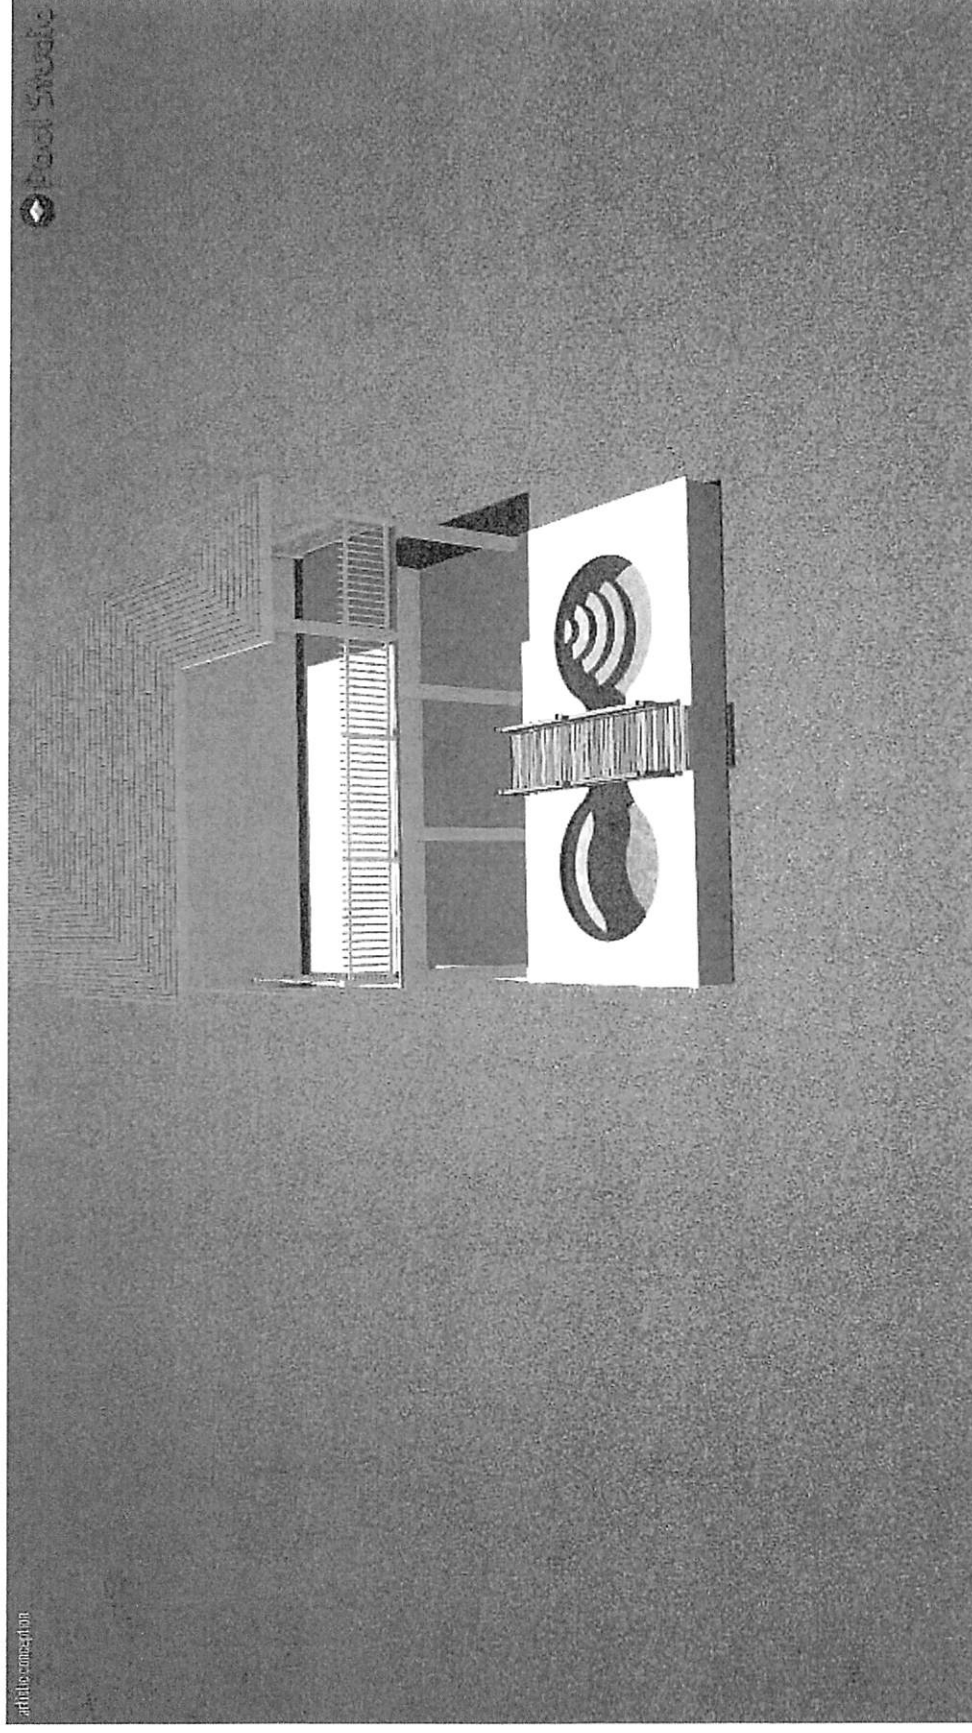

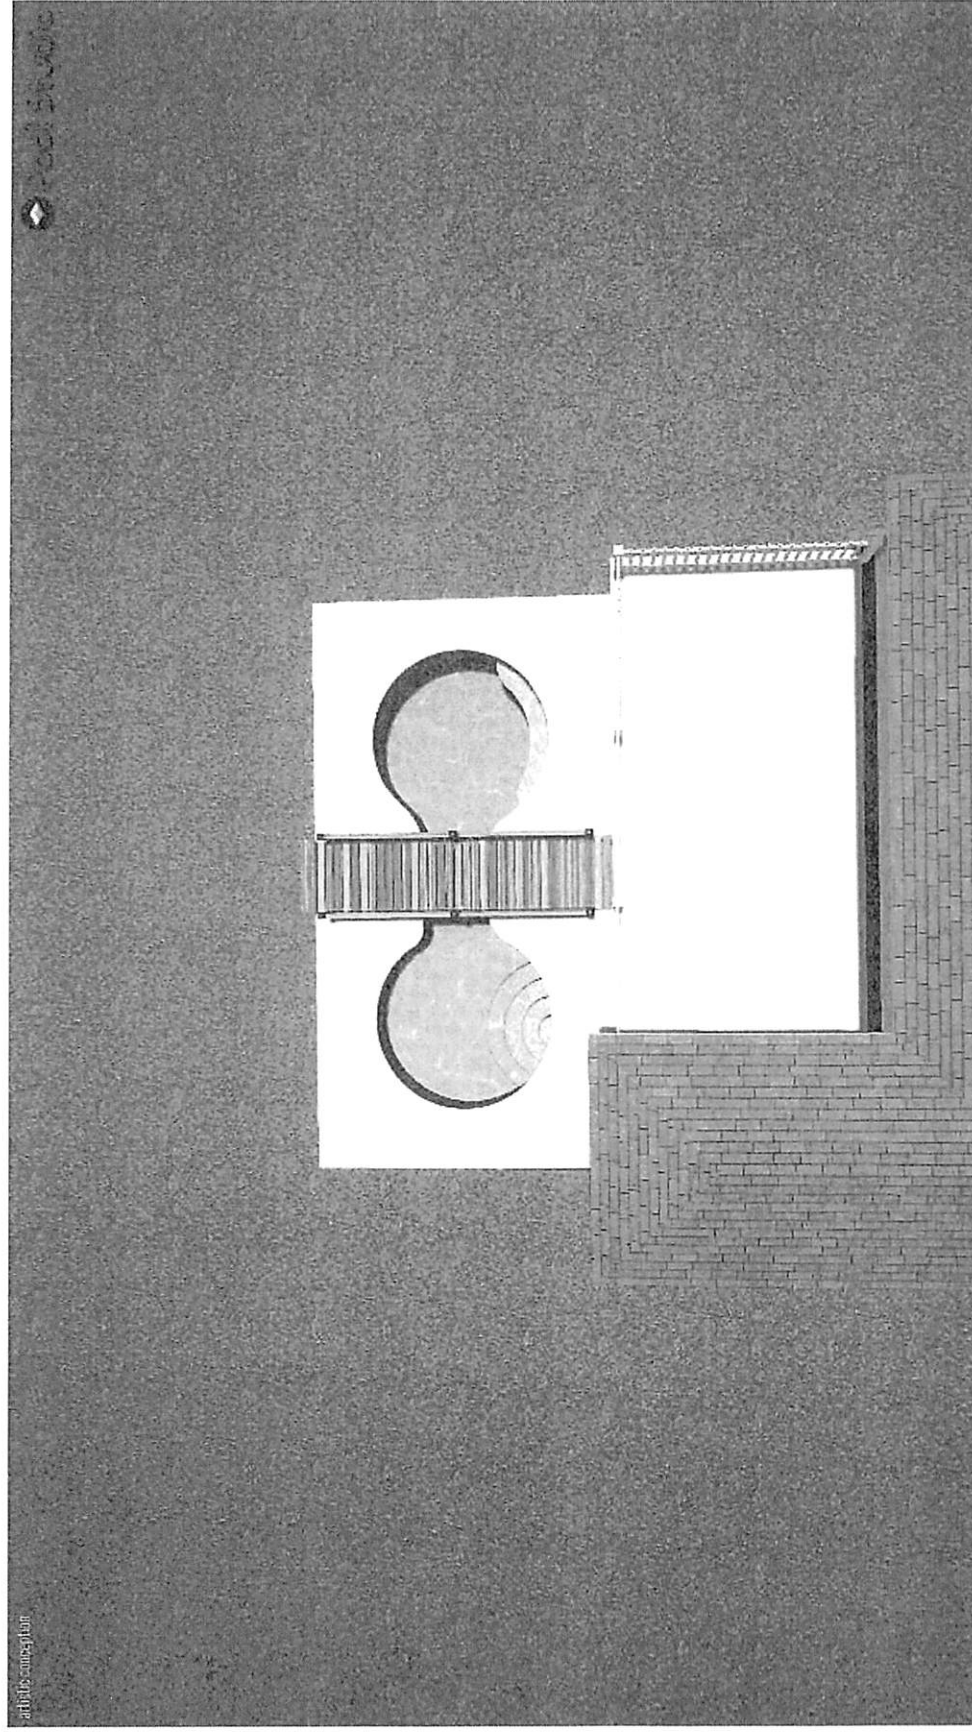

artist's conception

© 2001 BTR/ABC

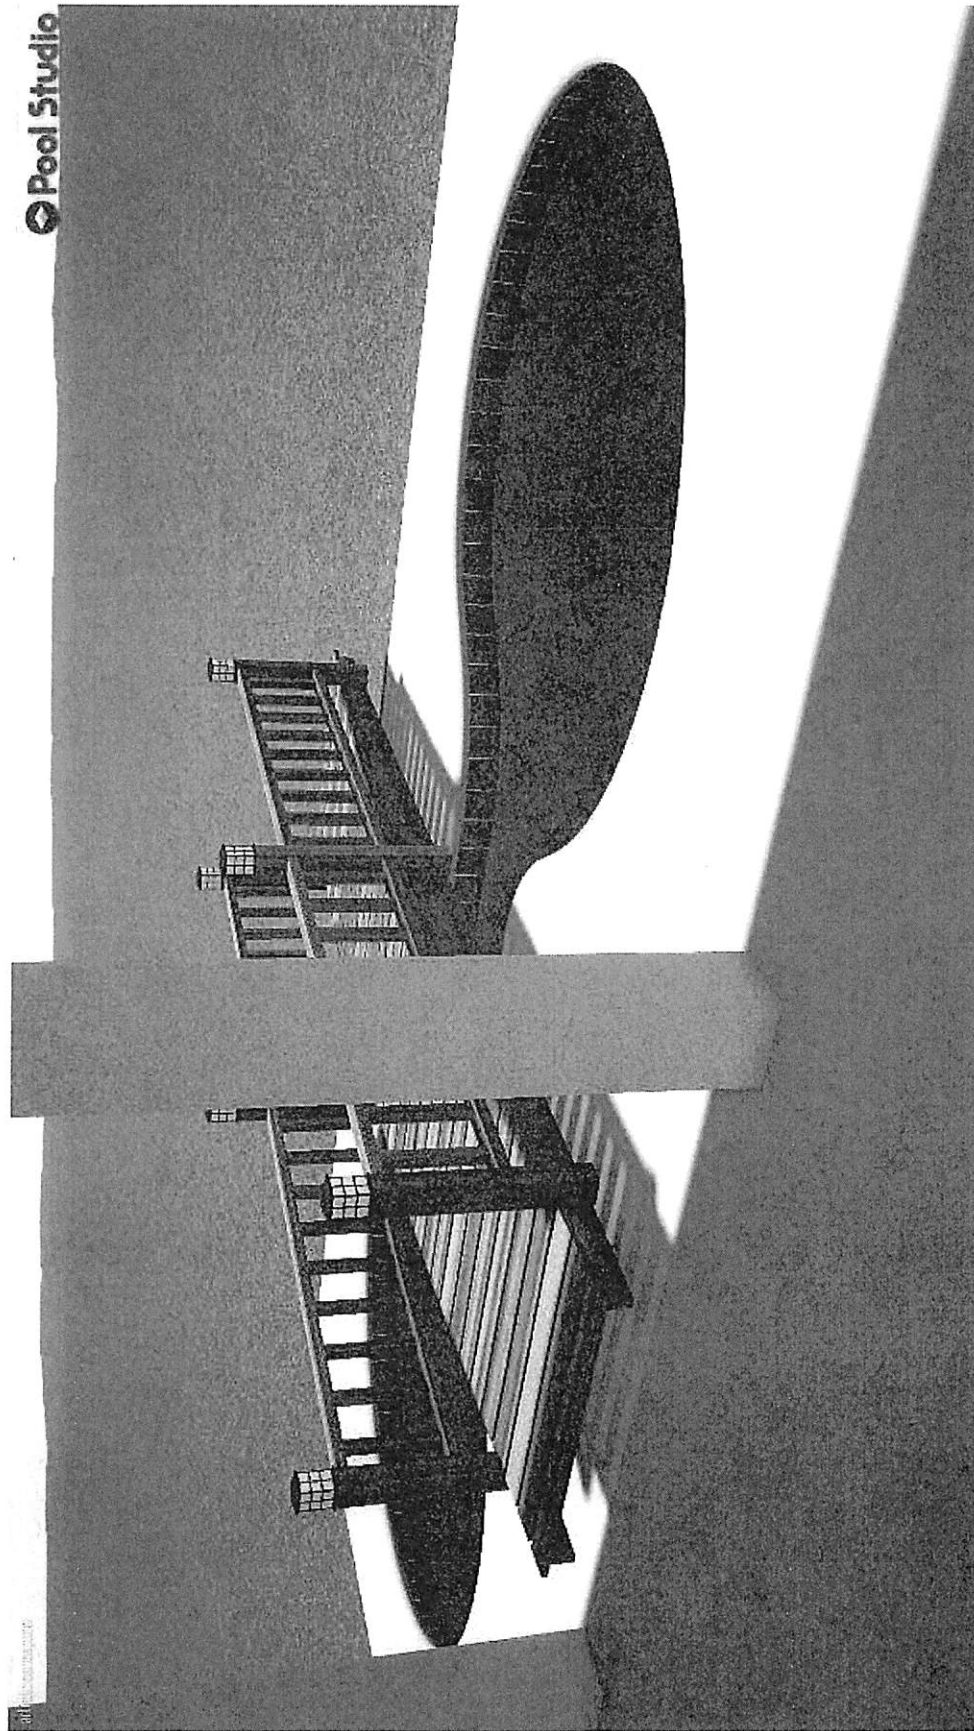


28' (P)  
DED)

8

SPL

171.23' (P)

25.00' (P)

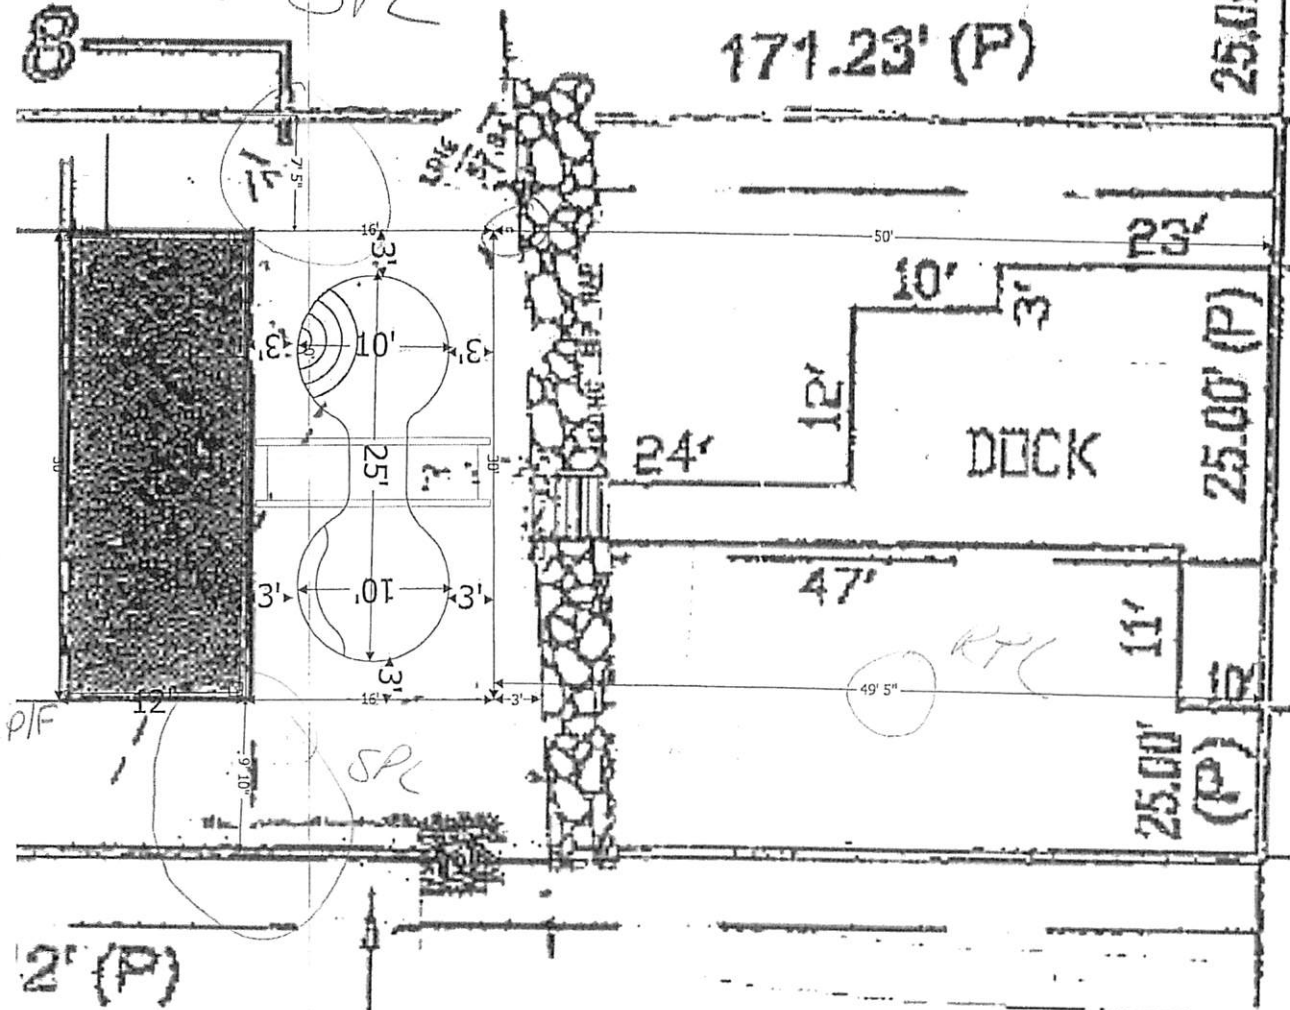

2' (P)  
DED)

BLOCK

PRDPOSED DOCK AT

Lot 18, except the Northernly 20 feet, all of Lot 19, and the Northernly 20 feet of Lot 20, Block B, Palmen Cove, according to the map or plat thereof, as recorded in Plat Book 95, Page(s) 65 through 69, inclusive, of the Public Records of Volusia County, Florida.

1. Limits and scope of Specific Purpose Survey identified by

1. Subject to restrictions, reservations, limitations, assessments and rights of way, if any, appearing of record.
2. This map of survey and report prepared without the benefit of an abstract and no title work has been performed or provided to this surveyor.
3. This map of survey and report is subject to any facts that

5. The location of any subareas, jurisdictions, improvements, features or utilities which may or may not exist and which may or may not be considered or assessed in the study are not determined or addressed by this survey.
6. Dimensions indicated herein are in U.S. standard feet and

- Coordinates (4-1 foot) refer to the Florida State Plane Coordinate System - East Zone, (1927 adjustment). Coordinates based on U.S. Army Corps of Engineers Monuments W-49 (X=536,777.70 Y=1,684,834.95) and W-50 (X=537,502.36 Y=1,683,949.00).

9. Drawing distance between features and property line may be exaggerated for clarity.  
10. Features shown by symbol ~~as~~ indicated are not to scale.  
11. Adjacent docks not located.  
12. A Mean High Water elevation that complies with Chapter 177, Part II, Florida Statutes ~~was~~ not located.

13. This Plat of Specific Purpose Survey is not an actual Boundary Survey, no monumentation set or recovered.
14. Additions or deletions to this survey map or report by other than the signing party or parties is prohibited without written consent of the signing party or parties per F.A.C. Rule 5-1.7-.051 (a)(b)(6).
15. The survey map and report and ~~thereof~~ <sup>therein</sup> are not valid

Florida licensed surveyor and mapper.

CERTIFIED TO:

DOUGLAS A. HENRY and VIGOR J. HENRY


[illegible]

LEGEND: 2. ABBREVIATIONS

[illegible]


CERTIFICATE OF AUTHORIZATION NUMBER LB 7843  
 hereby certify that the survey map and report of the subject property  
 as here and shown to the best of my knowledge, information and belief  
 as same appear on the face thereof, and the survey map and report meets the  
 minimum standards set forth in F.O. Rule 65-17, adopted  
 by the Florida Board of Professional Engineers and Geographers, pursuant  
 to Florida Statute Ch. 472.07, subject to the qualifications noted  
 hereon.  
 JAMES M. CORE, P.E., No. 2027  
 JEFFREY W. CORE, P.S.M., No. 4139

PREPARED FOR: DONG & WICKLE HENRY  
 SCALE 1" = 30' FILE# 4401-B  
 200 CANAL STREET  
 SUITE 400, LLC  
 DANIEL W. CORRY  
 NEW SMYRNA BEACH, FL 32074 32165  
 FAX (561) 427-1783  
 website: danielwcorry.com  
 (561) 427-5575  
 PANEL  
 THIS LOCATION IS OBTAINED FROM FLIGHT COMMUNITY  
 THIS PROPERTY IS LOCATED IN FEMA ZONE (0)  
 N/A  
 MAP REVISSED

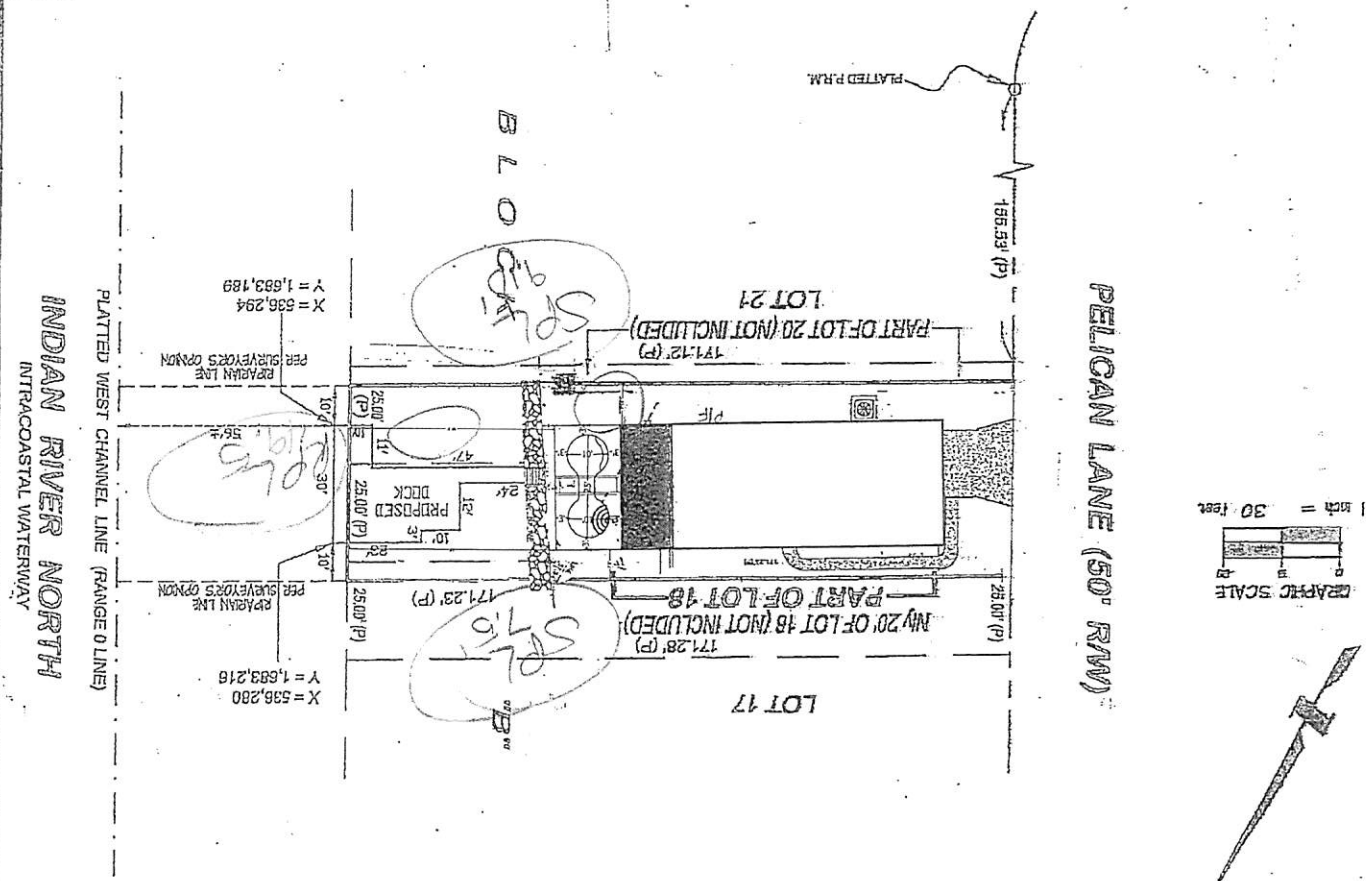

LOT 14 EXCEPT N 20'. ALL LOT 14 & N 20' OF LOT 20

MAP

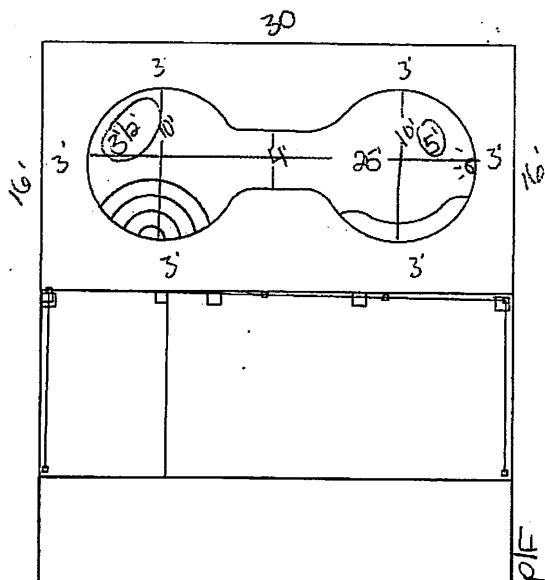

POOL PLAN

SCALE: 1/8" = 1'-0"


1. ELEVATION: DECK: \_\_\_\_\_ BEAM: \_\_\_\_\_
2. DIG & HAUL: \_\_\_\_\_ DROP: \_\_\_\_\_
3. POOL SHAPE: Custom FT. POOL/DECK: 170/309
4. DIMENSION: 10' x 25' x 4' DEPTHS: 3' 1/2' TO: 5'
5. TILE: Choice
6. CAP TILE: De Interp
7. DECKING TYPE: Acrylic COLOR: \_\_\_\_\_
8. DECK COPING: Acrylic
9. PUMP TYPE: Hammer SIZE: Trans 1/2 VS
10. FILTER TYPE: Hayward SIZE: Cartridge
11. UNDERWATER LIGHT: Yes
12. SANITIZER: Aqua Plus
13. AUTOMATIC TIMER: Yes
14. AUTOMATIC POOL CLEANER: Plumb + Valve
15. SKIMMER: Yes MAIN DRAIN: 2 RETURN INLETS: Yes
16. THERAPY JETS: \_\_\_\_\_ NO. OF JETS: \_\_\_\_\_
17. SWIM OUT: Yes HANDRAIL: \_\_\_\_\_
18. INTERIOR FINISH:  Pebble
19. TEST KIT: Yes BRUSH NET & POLE: Yes
20. MANUAL VAC: Yes VAC. HOSE: Yes
21. RAISED BEAM: \_\_\_\_\_ NO. OF LEVELS: 8
22. WATER FEATURES: \_\_\_\_\_
23. SPA: \_\_\_\_\_ THERAPY JETS: \_\_\_\_\_
24. SPA HEATER: \_\_\_\_\_ SPILLWAY: \_\_\_\_\_
25. POOL HEATING: \_\_\_\_\_
26. SCREEN ENCLOSURE, ROOF STYLE: \_\_\_\_\_ BRONZE: \_\_\_\_\_ WHITE \_\_\_\_\_
27. DOORS: \_\_\_\_\_ GUTTERS & DOWNSPOUTS: \_\_\_\_\_
28. ALUMINUM ROOF: \_\_\_\_\_
29. FENCE: By Owner
30. TREE REMOVAL: \_\_\_\_\_ STUMP REMOVAL: \_\_\_\_\_
31. CONCRETE REMOVAL: \_\_\_\_\_
32. BUILDER: \_\_\_\_\_
33. OTHER: Alarm

SDVservicesdk@yahoo.com

**Bob Herrold's**  
**All Seasons Swimming Pools & Spas, Inc.**

322 N. Dixie Freeway  
New Smyrna Beach (386) 423-2330

NAME: Dell Kelley  
ADDRESS: 21 Pelican Lane  
CITY: Edgewater PHONE # 321-543-4211  
LOT NO. \_\_\_\_\_ SUBDV. \_\_\_\_\_  
CUST. SIG. \_\_\_\_\_  
OCCUPIED: \_\_\_\_\_ UNDER CONSTRUCTION \_\_\_\_\_

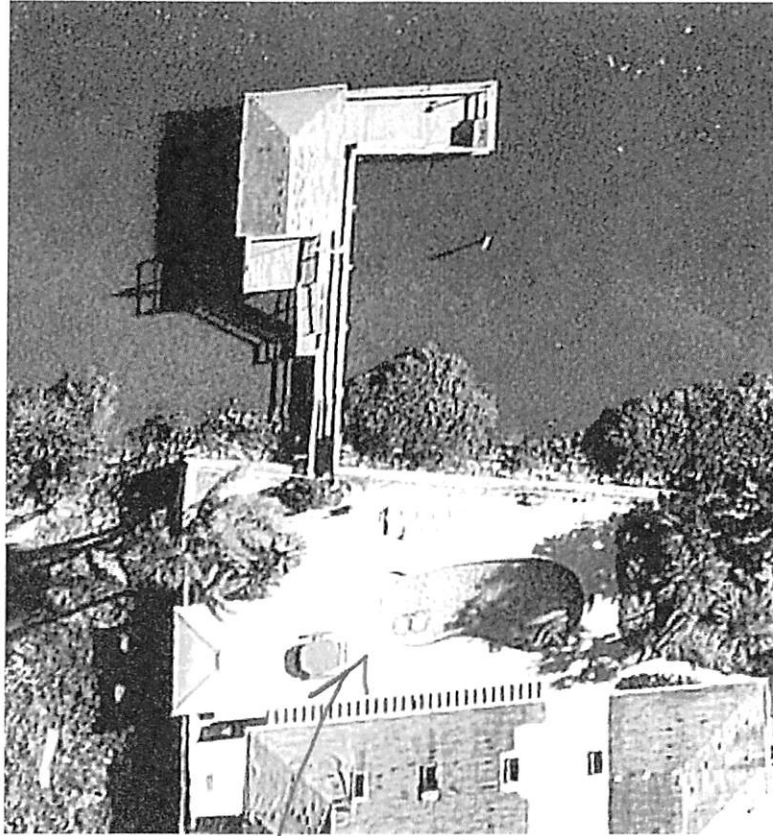

#3 PELICAN LANE

\*NOTICE FULLY IMPERVIOUS AREA FROM REAR OF  
HOME TO MHW