

CONSTRUCTION OBSERVATION


1. CONSTRUCTION OBSERVATION REPORTS FOR CONSTRUCTION ADMINISTRATION SERVICES ARE NOT A PART OF ARCHITECT'S SERVICES OR OBLIGATIONS.
2. IT IS UNDERSTOOD AND AGREED THAT ARCHITECT'S REVIEW OF SERVICES DOES NOT INCLUDE PROJECT CONSTRUCTION OBSERVATION. THE CLIENT'S OBLIGATION IS TO PROVIDE THE ARCHITECT WITH THE NECESSARY INFORMATION TO ALLOW THE ARCHITECT TO PROVIDE THE CONSTRUCTION OBSERVATION. THE ARCHITECT'S OBLIGATION IS TO PROVIDE THE CONSTRUCTION OBSERVATION.

NOTES

1. RETAINING WALL & POOL SITE PLAN
2. RETAINING WALL DETAILS & POOL LOCATION PLAN

STATE OF FLORIDA
PROFESSIONAL ARCHITECT

Roland Abouchakra, AIA
Florida License No. AR93723

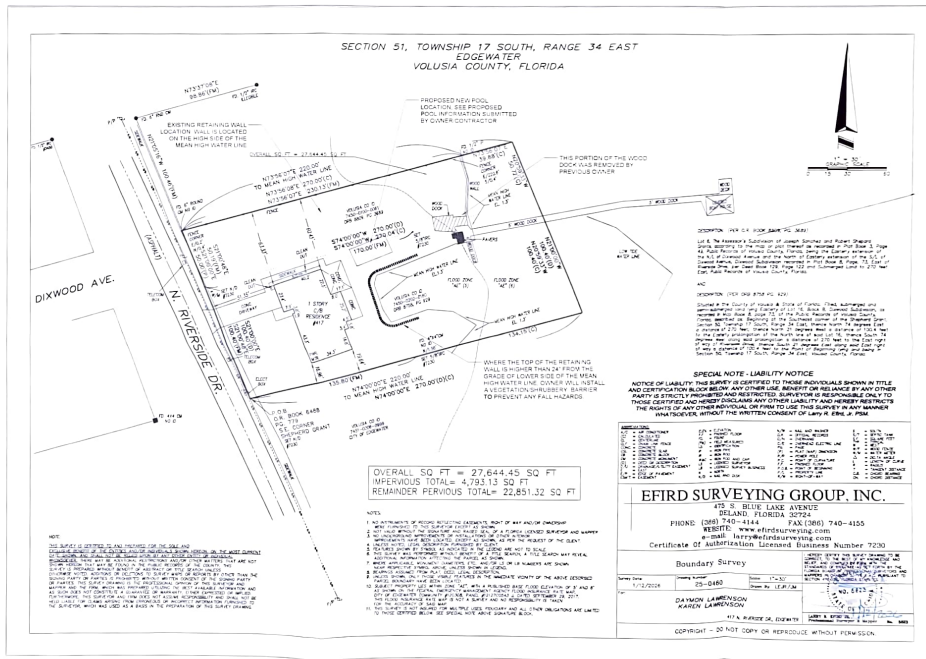

AS-BUILT RETAINING WALL
& PROPOSED POOL LOCATION PLAN
(FOR REFERENCE ONLY)

DATE: 05/15/2024

SCALE: 1/4" = 1'-0"

SHEET

DATE: 05/15/2024

SCALE: 1/4" = 1'-0"

SHEET

DATE: 05/15/2024

SCALE: 1/4" = 1'-0"

SHEET

DATE: 05/15/2024

SCALE: 1/4" = 1'-0"

SHEET

DATE: 05/15/2024

STATE OF FLORIDA
ARCHITECT
ROLAND ABOUCHAKRA, AIA
FLORIDA LICENSE NO. AR93723

ROLAND ABOUCHAKRA, AIA
FLORIDA LICENSE NO. AR93723

